




- NOTES:**
1. DFT SPECIFICATION FOR HIGHWAY WORKS MAR 1998 APPLIES WITH ADDITIONS AND AMENDMENTS AND ANY BATH & NORTH EAST SOMERSET COUNCIL ADDITIONAL OR SUBSTITUTE CLAUSES.
  2. ALL DIMENSIONS ARE IN METRES.
  3. ALL SIGNING AND ROAD MARKINGS TO BE LAID IN ACCORDANCE WITH THE TRAFFIC SIGNS AND GENERAL ARRANGEMENT.
  4. DRAWING TO BE READ IN CONJUNCTION WITH DRAWING NO. TR5500/800/03.
- KEY:**
- FOOTWAY COMPRISING AC6 DENSE SURF 100/150 SURFACE COURSE 20mm THICK OF AC20 DENSE BIN 100/150 REG AS REGULATING COURSE SLOPING AT MORE THAN 10° TO THE HORIZONTAL.
  - PRE-CAST CONCRETE KERBS TYPE BN LAID STRAIGHT OR CURVED EXCEEDING 12 METRES RADIUS.
  - FOOTWAY COMPRISING 400mm X 400mm X 50mm TACTILE PAVING FLAG IN GREY ON TYPE 1 MIXTURE 150mm THICK AND 30mm SAND BED AT SLOPING AT 10° OR LESS TO THE HORIZONTAL.
  - 400mm X 400mm GREY TACTILE PAVING TILES APPLIED WITH AN EPOXY GLUE TO MANUFACTURERS RECOMMENDATIONS.
  - 50mm Ø P-VCU ORANGE DUCTING TO BE LAID WITH IN NEW FOOTWAY AREA (NO EXCAVATION REQUIRED).
  - BUS STOP OR BUS STAND TO TSGRD REF: 1025.1 COMPRISING YELLOW INTERMITTENT LINES 1000mm MARK, 1000mm GAP, 1000mm WIDE, CONTINUOUS YELLOW LINE 200mm WIDE & LETTERS 1600mm HIGH.
  - JISLON POLE CONES @ 2M C/C
  - TRAFFIC SIGNAL EQUIPMENT TO BE UNDERTAKEN BY OTHERS.
  - DEEP CREAM LINES TO DIAG. NO. 1016.1 50mm WIDE AND 50mm OFFSET.
  - KERB MARKS TO DIAG. NO. 1019
  - NEW METAL PEDESTRIAN CROSSING STUDS TO TO DIAG. NO. 1055

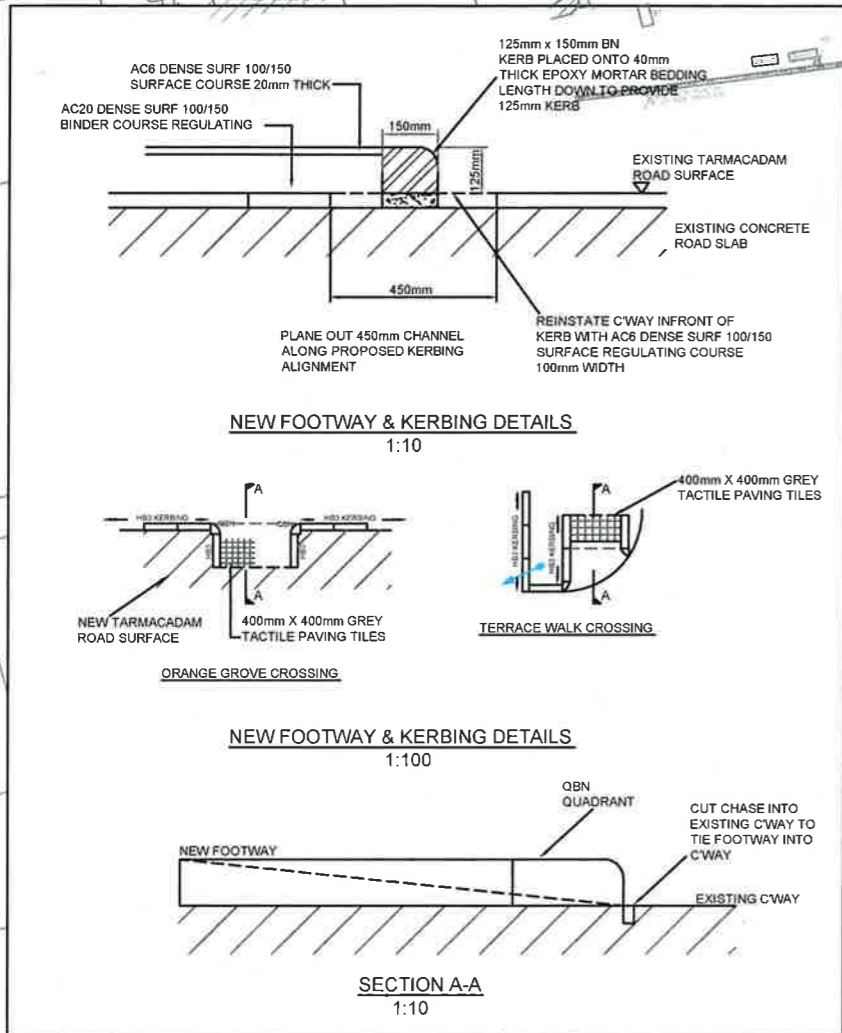

**AS BUILT**

This map is based on Ordnance Survey material with the permission of the Controller of Her Majesty's Stationery Office Crown Copyright. Unauthorised reproduction infringes Crown Copyright and may lead to prosecution or civil proceedings. BATH AND NORTH EAST SOMERSET COUNCIL Licence No. 100023334

Church of St Peter and St Paul

Kingston Buildings

Abbey Chambers

Friends Meeting Ho

**Bath & North East Somerset Council**

STEVE FROGGATT, BSc. (Hons) C.Eng MICE MIHT  
DESIGN & PROJECTS MANAGER  
ENVIRONMENTAL SERVICES

PRODUCED BY  
**DESIGN GROUP**

SCHEME TITLE  
**HIGH ST, BATH PUBLIC REALM & HIGHWAY IMPROVEMENT SCHEME: TERRACE WALK EXPERIMENTAL ROAD SPACE RE-ARRANGEMENT**

DRAWING TITLE  
**GENERAL ARRANGEMENT**

REV.	DATE	REVISIONS	DRWN.	CHKD.	APPROV.
C	01.8.12	AS BUILT ISSUE	DST	DST	SC
B	12.6.12	Road marking changes.	DST	DST	SC
A	31.5.12	Additional bollards and road markings	DST	DST	SC

DATE	APR 2012	DRAWN BY	DMM	APPROVED BY	SJF
SCALE	1:250@A1	CHECKED	DST		
CLIENT REF.					
DRAWING No.	TR5500/800/02				REV. C