

**LOCAL GOVERNMENT (MISCELLANEOUS PROVISIONS) ACT 1982
PART VIIA HIGHWAYS ACT 1980**

PERMISSION TO PLACE TABLES AND CHAIRS ON THE HIGHWAY

Gascoyne Place 1 SawClose Bath BA1 1EY

I/We Martin Grant



hereby give notice that I/we intend to apply for a licence in accordance with the particulars in the attached Schedule.

I/We enclose an illustration/photo of the type, colour and dimensions of the furniture (no change to furniture from last year)

I/We enclose a site plan indicating the dimensions of the area of highway upon which we wish to place the above furniture (all plans should be drawn to scale)

- (a) I/We enclose the application fee of £115
- (b) I/We also enclose £30 per table x 15 tables = £450
- (c) I/We enclose the total fee of (the sum of (a) + (b) above) £565

I/We declare that the information given in this application is true.

Signed by the applicant(s)

Dated 18/03/11

Please return the completed application to:

Licensing Services
Bath & North East Somerset Council
9 - 10 Bath Street
Bath BA1 1SN

**Local Government (Miscellaneous Provisions) Act 1982
Part VIIA Highways Act 1980
Permission to Place Tables and Chairs on the Highway at Gascoyne Place
1 Gascoyne Place Saw Close Bath BA1 1EY**

1

Full name and address of each holder of the licence

Mr Martin Grant
1 Gascoyne Place
Sawclose
Bath
BA1 1EY

2

Contact telephone number

marty.grant@gascoyneplace.co.uk

3

The date or dates, or the period of time for which the licence is required (maximum one year)

From: 1 April 2011
To: 31 March 2012

4

Number of tables

15

5

Size/Dimensions of area

~~200~~ square metres
100 (80 SQM + 20 SQM)

6

The Council must notify any "affected frontages" of this application. Please provide details of the adjoining premises.

Raphael's restaurant, Upper Borough Walls. This business is not have directly affected as it has no frontage onto Sawclose. In addition, this business is closed on Sunday's which is the main day of the week when there would be partial road closure application permissions.

7

Days of the week and hours of operation on those days

11.00 -23.00 (Weekends and Bank Holidays)

8

Specific part of the premises proposed to be licensed

Upper Borough Wall & Sawclose Car Park

9

Alcohol permitted


Yes

10

If yes, please state your premises licence number

05/04535/LAPRE

11/00228/TABLE

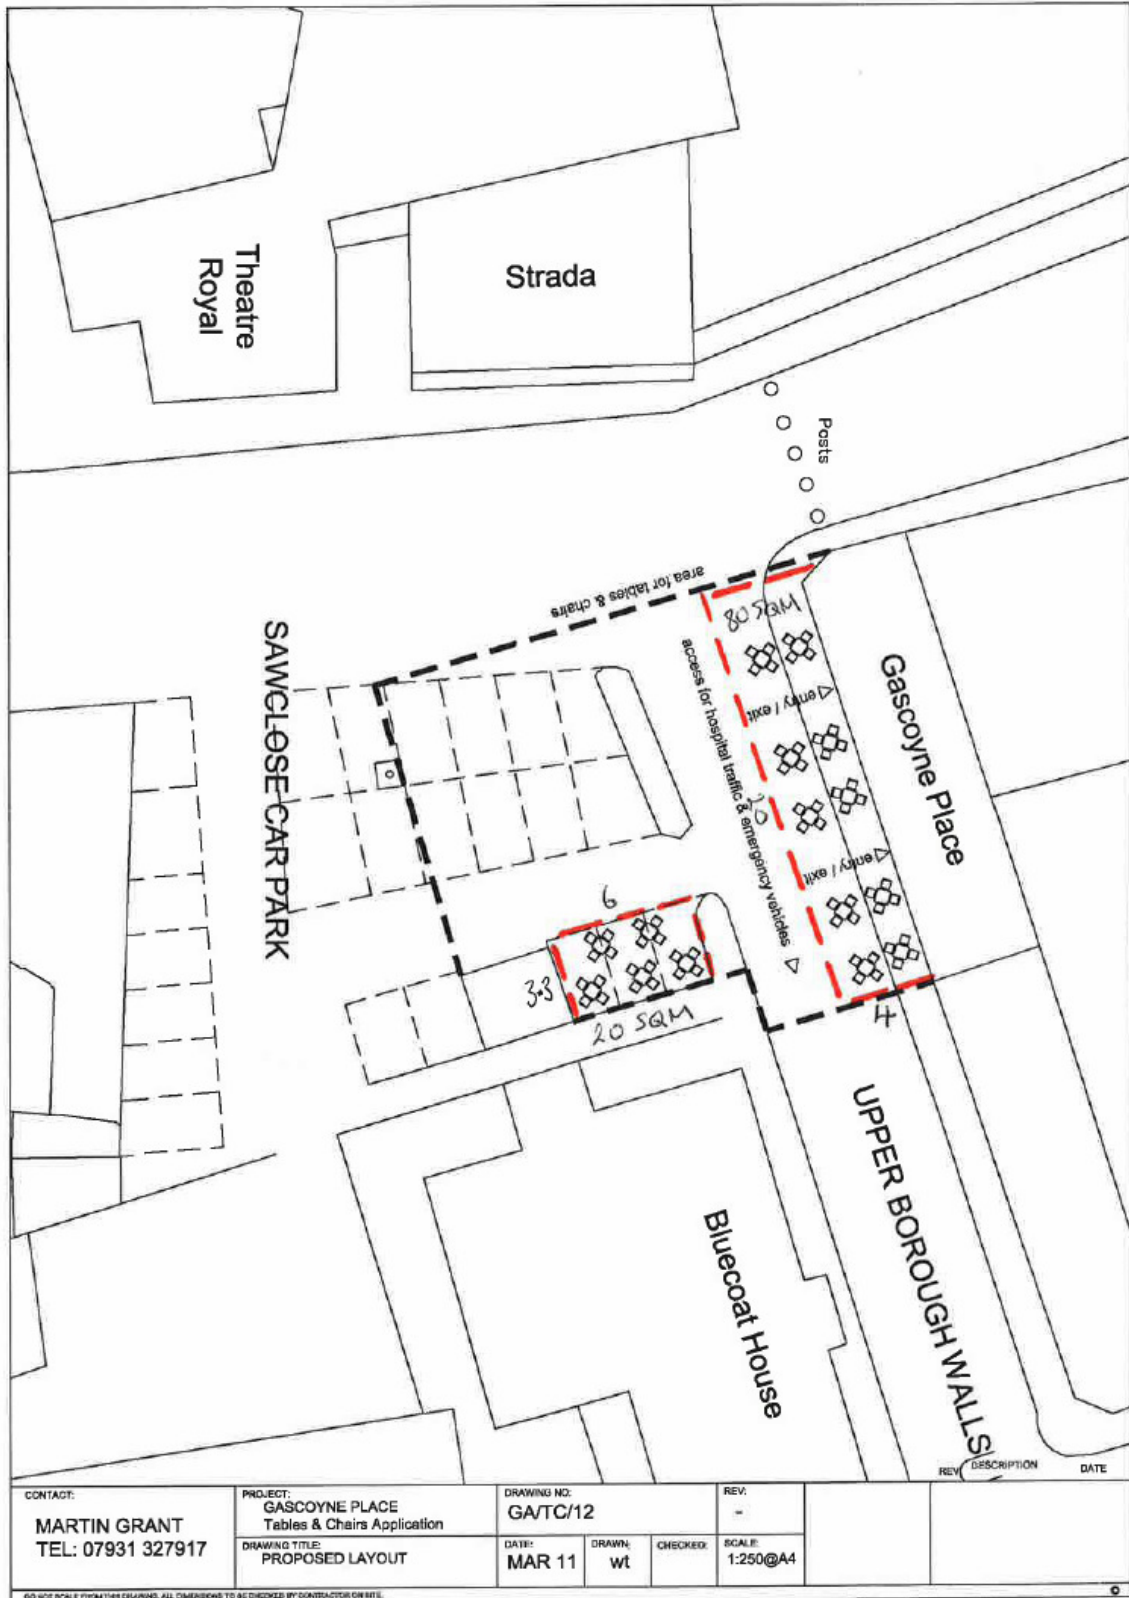

REV	DESCRIPTION	DATE

CONTACT: MARTIN GRANT TEL: 07931 327917	PROJECT: GASCOYNE PLACE Tables & Chairs Application	DRAWING NO: GATC/12	REV: -
DRAWING TITLE: PROPOSED LAYOUT	DATE: MAR 11	DRAWN: wt	CHECKED: SCALE: 1:250@A4

DO NOT SCALE FROM THIS DRAWING. ALL DIMENSIONS TO BE DIMENSIONED BY CONTRACTOR ON SITE.